



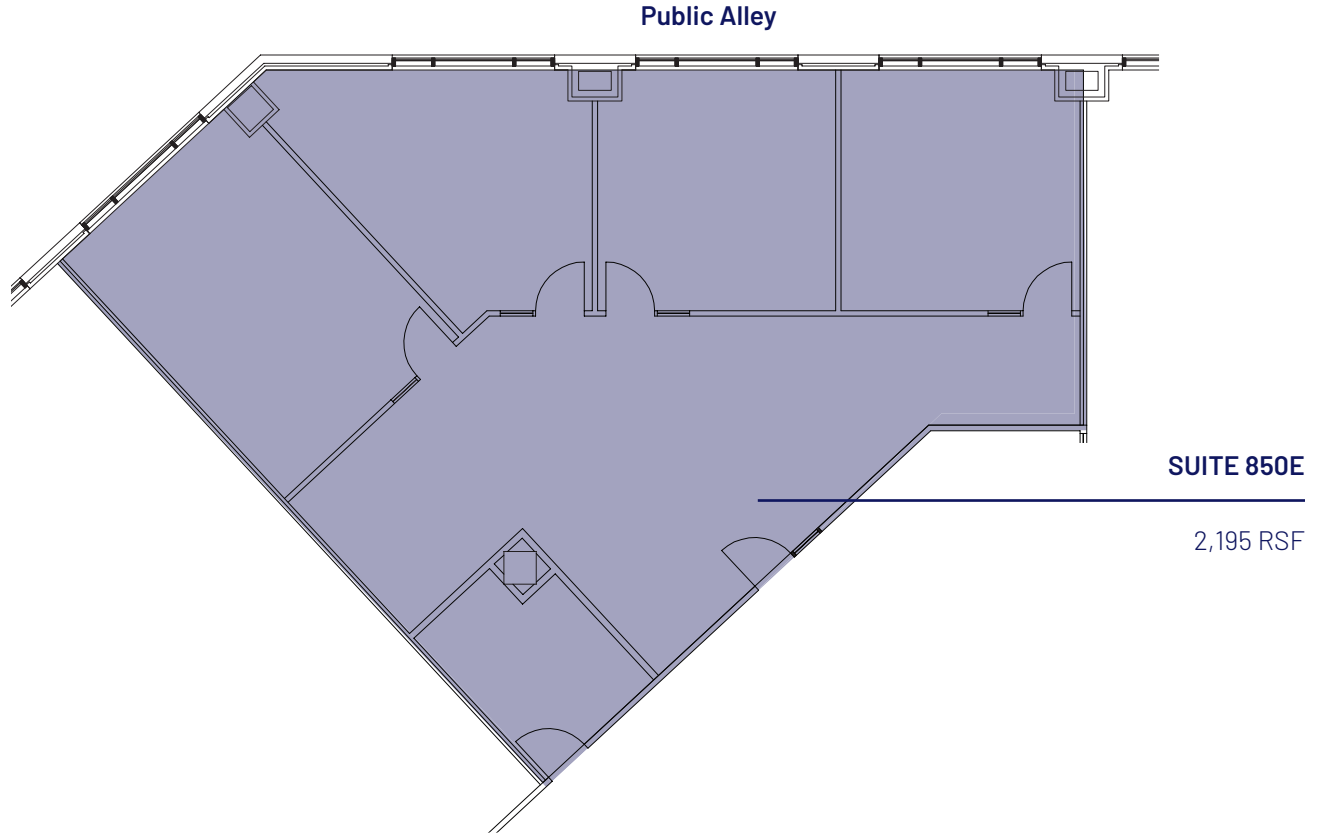

8TH FLOOR

AS-BUILT PLAN

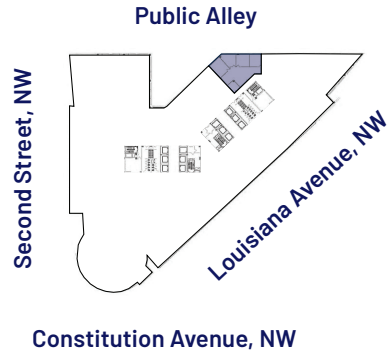

**Amy Bowser**  
amy.bowser@am.jll.com  
202 719 5600

**Brooks Brown**  
brooks.brown@am.jll.com  
202 719 6244

**Melissa Byrd**  
melissa.byrd@am.jll.com  
202 719 5858

**Will Donohue**  
will.donohue@am.jll.com  
202 719 5739