



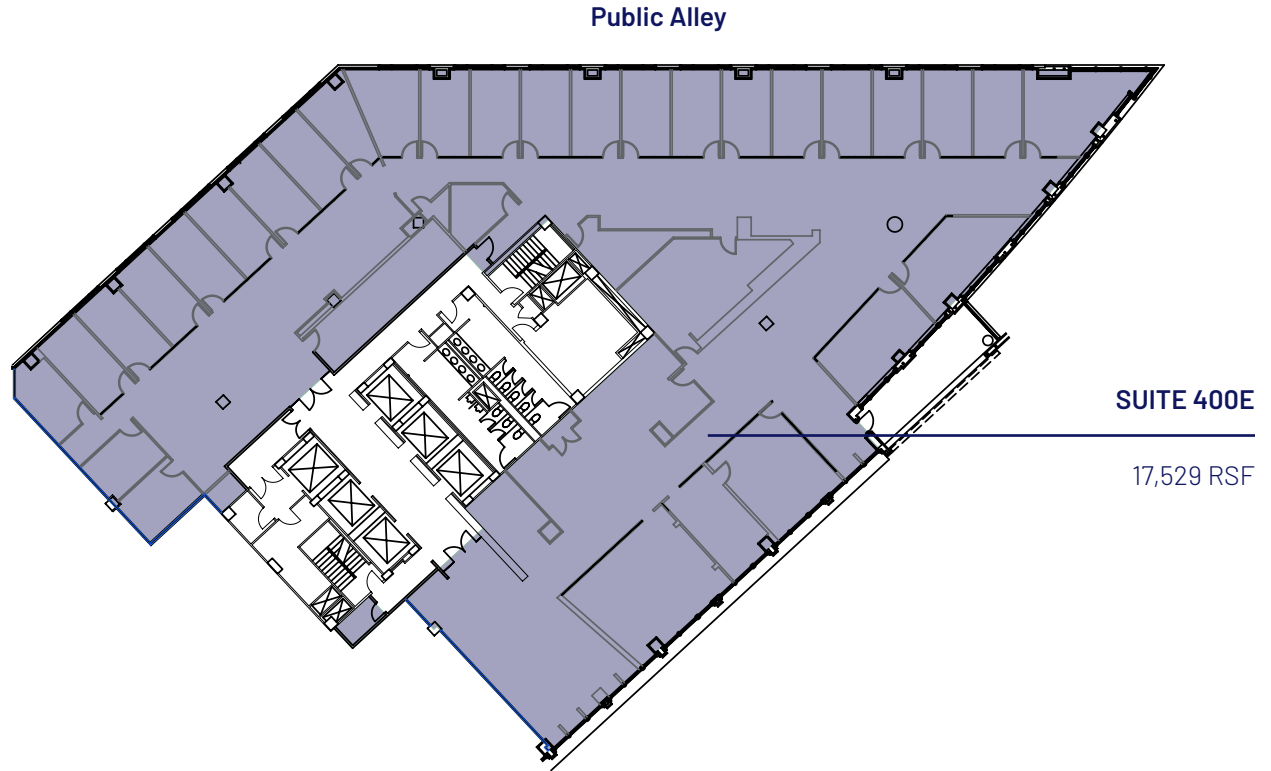

4TH FLOOR

AS-BUILT PLAN

AVAILABLE 8/1/23

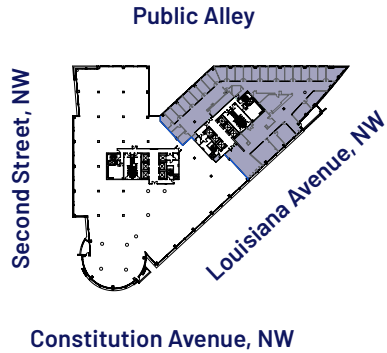

Amy Bowser
amy.bowser@am.jll.com
202 719 5600

Brooks Brown
brooks.brown@am.jll.com
202 719 6244

Melissa Byrd
melissa.byrd@am.jll.com
202 719 5858

Will Donohue
will.donohue@am.jll.com
202 719 5739