



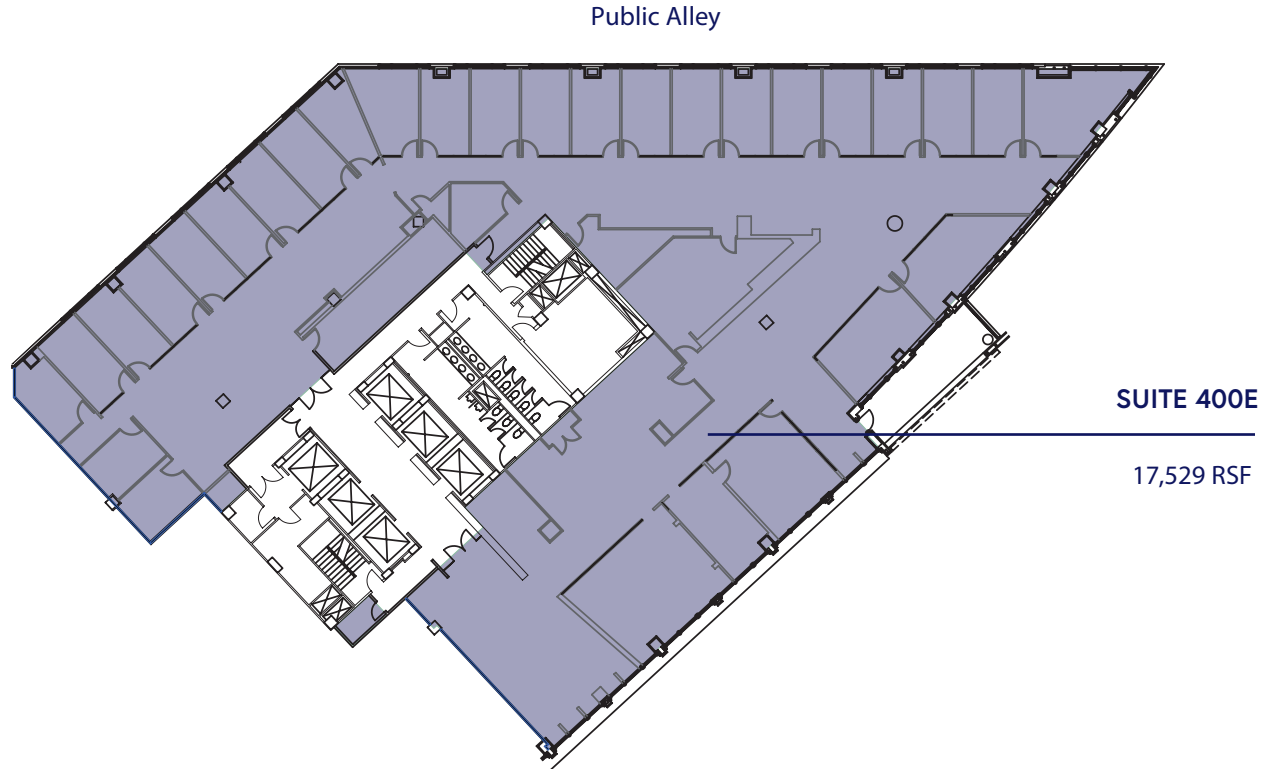

4TH FLOOR

AS-BUILT PLAN

AVAILABLE 8/1/23

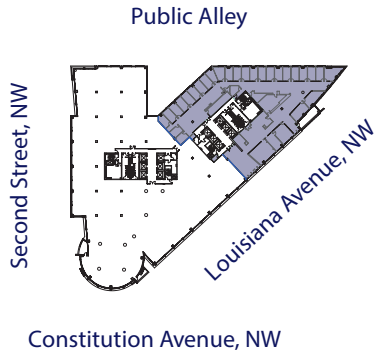

For leasing inquiries
please contact:

Amy Bowser
amy.bowser@cbre.com
202 423 2196

Brooks Brown
brooks.brown@cbre.com
202 423 2193

Will Donohue
will.donohue@cbre.com
202 423 2194